61182

61182

PLACE

Sub Doc Type

BL

Number LG Docs

0003

Box Number

Street #

370

Street Dir

S

Doc Type

PL

Street Name

WINCHESTER

Street Type

BL

Tract Number

Document Date

11/18/86

	Prepped By	Scanned By	Indexed By	Verified By
Initials				
Date	5-5-01			

100'

50'

EXISTING KITCHEN, BAR, TOILET ROOMS & SERVICE & STORAGE AREAS

W

M

DRESS

J

HM

OFFICE STORAGE

NEW WALL

VIP ROOM

ADD PORTABLE PARTITION

VIP ROOM

CASHIER

ENTRY

WALL TO BE REVISED

SEE REVISED KITCHEN DETAILS

REVISED WALL

EXISTING CANOPY HOOD

WALL AND STORAGE TO BE REMOVED

STORAGE

WAITER WORK AREA

OFFICE - STORAGE

ELECT. METER & PANEL

VIP ROOM

EXISTING EMERGENCY EXIT W/PANIC HARDWARE

EXISTING EMERGENCY EXIT W/PANIC HARDWARE

PROPOSED CHINESE RESTAURANT

370 S. WINCHESTER BLVD., SAN JOSE, CA.

SCALE: 1/8" = 1' 0"		DRAWN: L. YEE
DATE:		REVISED:

61182 1635

EXISTING KITCHEN, BAR, TOILET ROOMS & STORAGE AREAS

W

M

OFFICE STORAGE

NEW WALL

DRESS

WH

WALL TO BE REMOVED

SEE REVISED KITCHEN DETAILS

FENCED WALL

EXISTING GREASE HOOD

WALL AND SHELVING TO BE REMOVED

SINKS

OFFICE - STORAGE

ELECT. METER & PANEL

WATER HEATER

EXISTING EMERGENCY EXIT W/PANIC HARDWARE

M.P. ROOM

ADD PORTABLE PARTITION

V.I.P. ROOM

CASHIER

ENTRY

V.I.P. ROOM

EXISTING EMERGENCY EXIT W/PANIC HARDWARE

San Jose/Santa Clara
Water Pollution Control Plant
Industrial Waste Section

☒ Approved on 9/26/80
By D. M. Pyatt

☒ See Comments Below:
Existing 1,500 gallon grease interceptor will satisfy our requirements.

61182 1635

& '82
EXCEPTION

PROPOSED CHINESE RESTAURANT
570 S. WINCHESTER BLVD., SAN JOSE, CA

SCALE: 1/8" = 1'-0"
DRAWN: L. YEE
DATE:
REVISIONS:

2

61182F

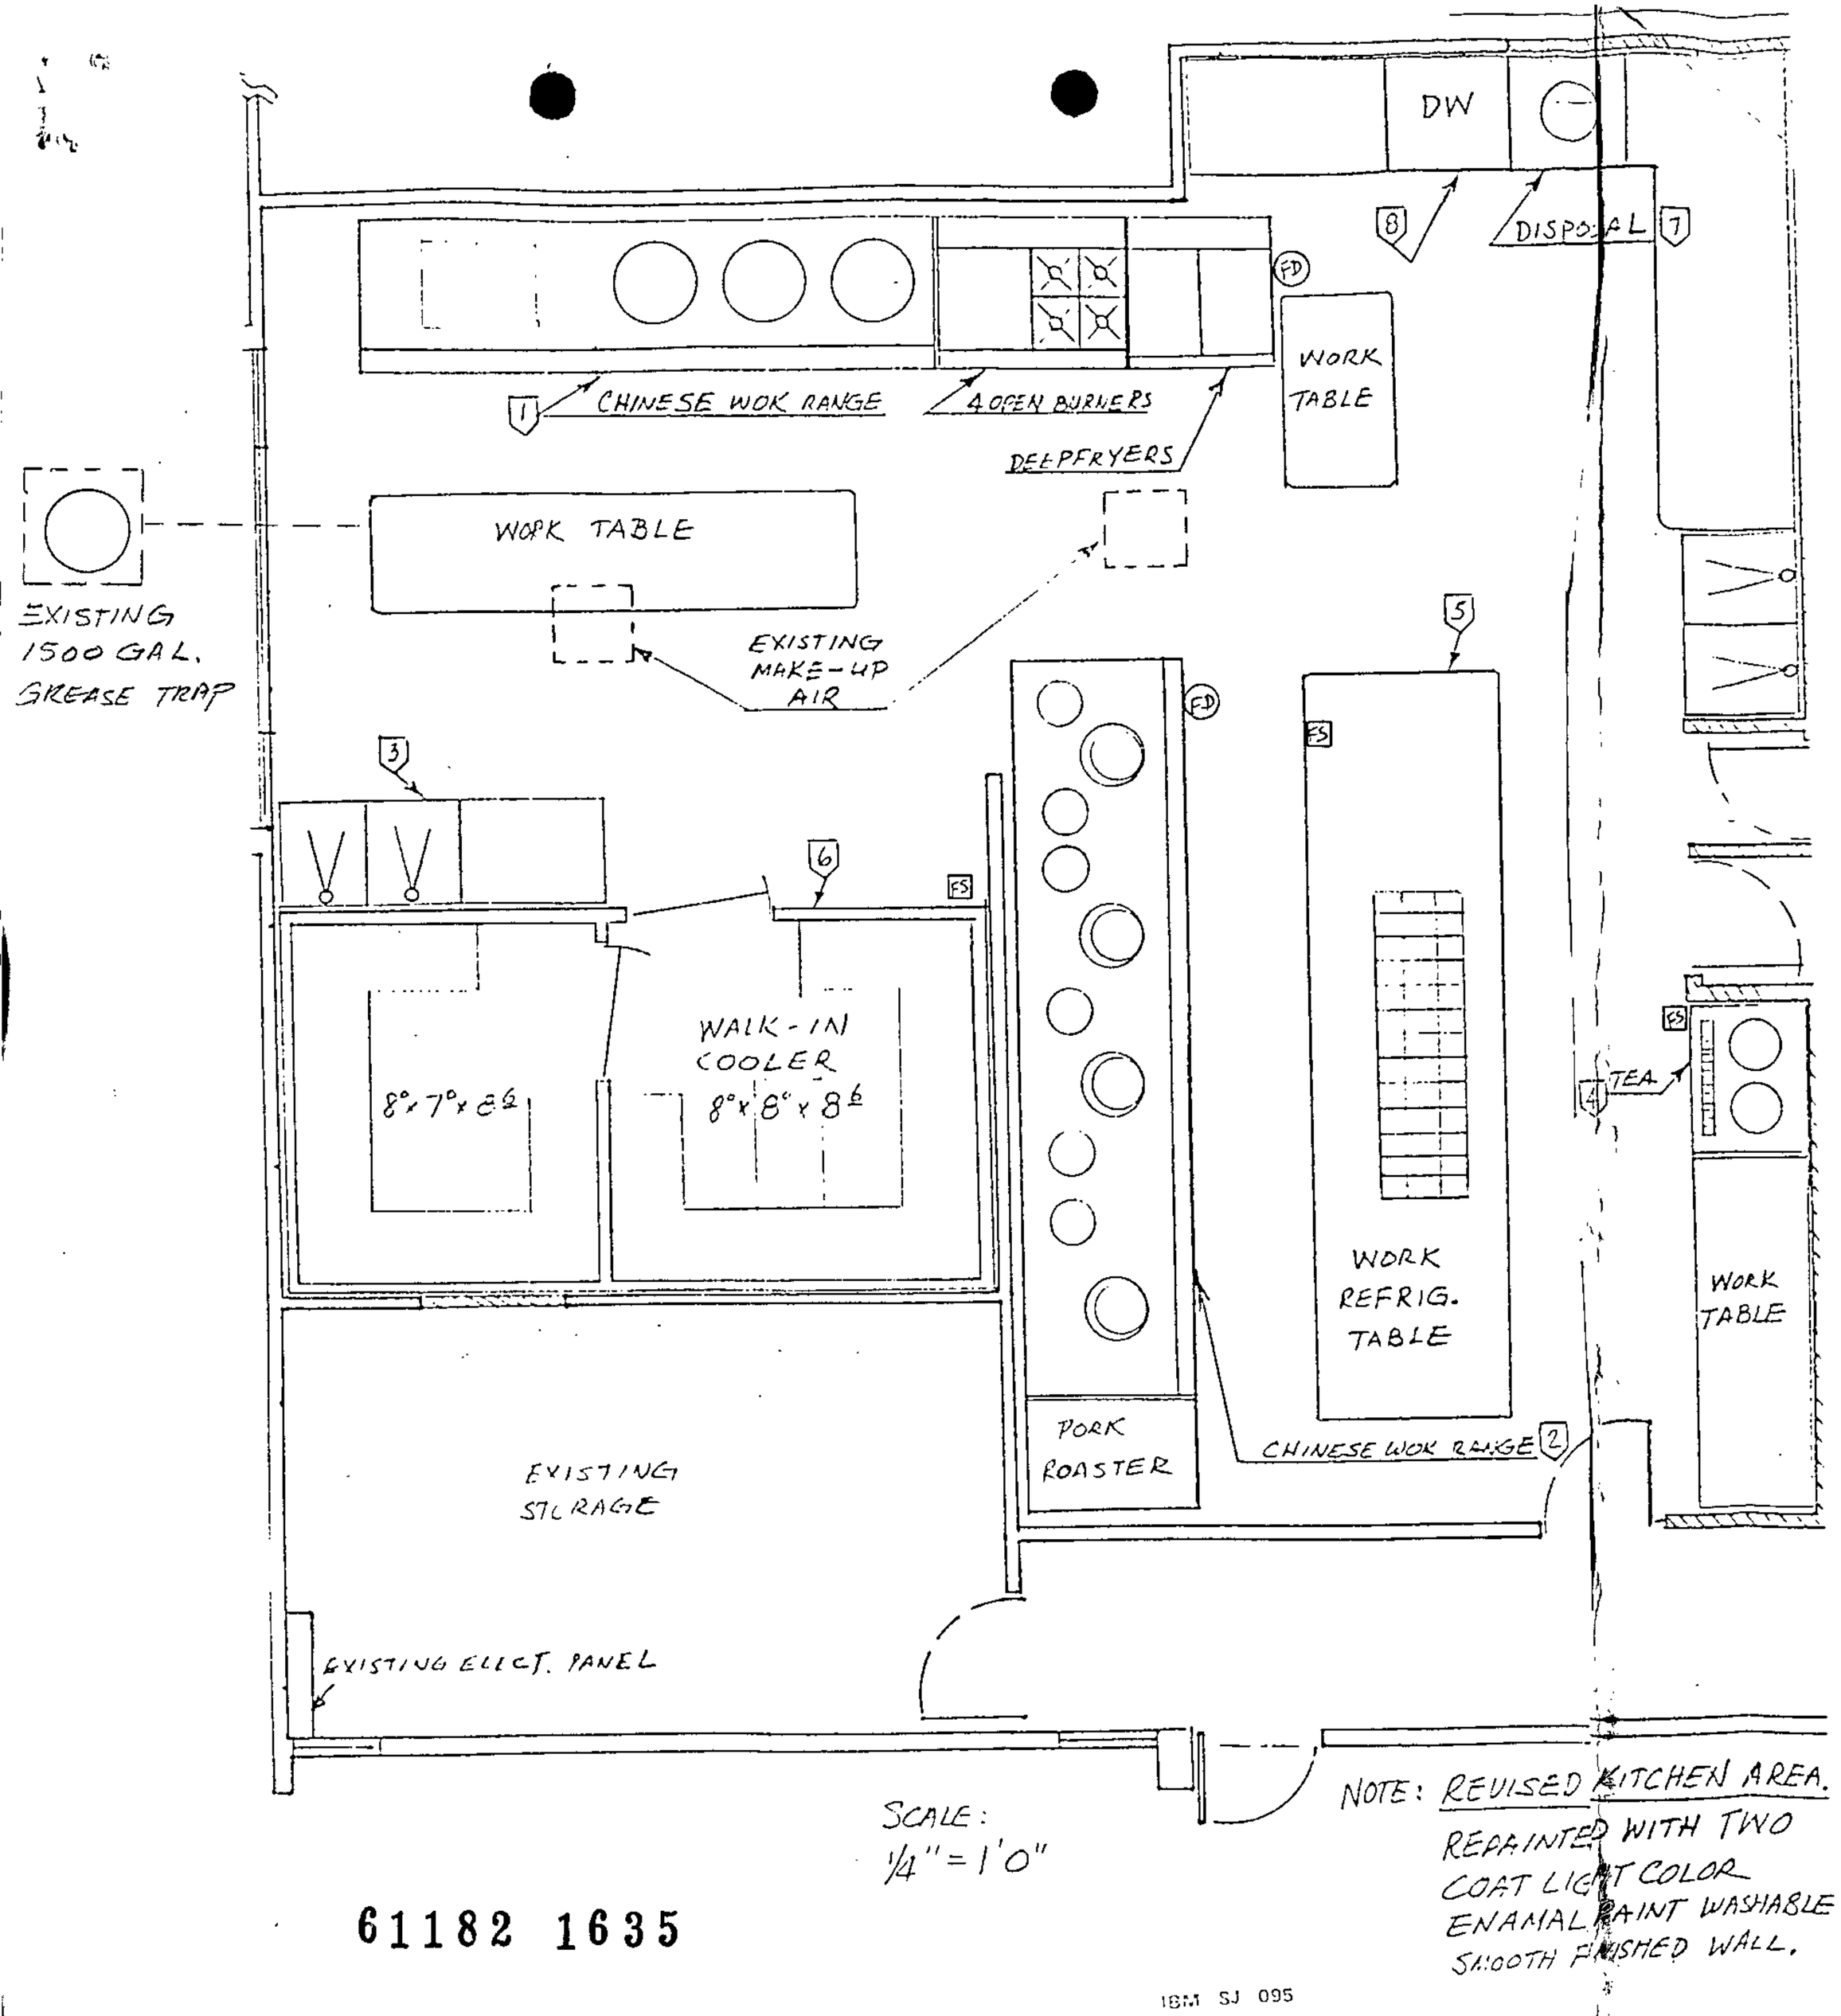

SCALE:
¼" = 1'0"

NOTE: REVISED KITCHEN AREA.
REPAINTED WITH TWO COAT LIGHT COLOR ENAMAL PAINT WASHABLE SMOOTH FINISHED WALL.

61182 1635

IBM SJ 095

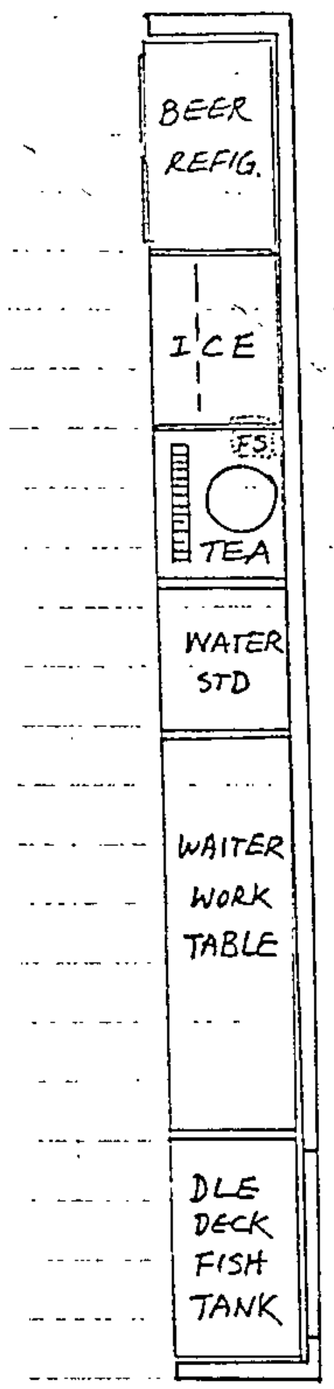

3

IBM SJ 095